

counterparts. Each such counterpart, when executed and delivered, shall be an original, but all such counterparts together shall constitute a single document. Signature and acknowledgment pages may be detached from the counterparts and attached to a single copy of this document to physically form one document.

Signature page(s) to follow.

IN WITNESS WHEREOF, the undersigned have caused these presents to be duly
executed the day and year first herein above written.

WITNESSES:

Claudia Paul
Kellen Shuler

NORTH POINTE DEVELOPMENT, INC.

By: [Signature]
Name: JAMES LANDRUM
Title: V-PRES.

STATE OF SOUTH CAROLINA
COUNTY OF Horry

ACKNOWLEDGEMENT

I, Dobres Morales a Notary Public for South Carolina, do hereby certify that
James Landrum personally appeared before me this day and acknowledged the due
execution of the foregoing instrument.

Witness my hand and seal this 28th day of October, 2019.

[Signature]
My Commission Expires
My Commission Expires 4-28-20

WITNESSES:

Candice Law
Kelce Shaha

NORTH POINTE DEVELOPMENT
HOMEOWNER'S ASSOCIATION, INC.

By: [Signature]
Name: JAMES LANDRUM
Title: V.PRES.

STATE OF SOUTH CAROLINA
COUNTY OF Horry

ACKNOWLEDGEMENT

I, Dolores Morales a Notary Public for South Carolina, do
hereby certify that James Landrum personally appeared before me this day and
acknowledged the due execution of the foregoing instrument.

Witness my hand and seal this 28th day of October, 2019

[Signature]
My Commission Expires 03-14-2028

**HORRY COUNTY REGISTER OF DEEDS
TRANSMITTAL SHEET**

**TO BE FILED WITH EACH INSTRUMENT PRESENTED ELECTRONICALLY FOR RECORDING.
HORRY COUNTY REGISTER OF DEEDS, 1301 SECOND AVENUE POST OFFICE BOX 470 , CONWAY ,
SOUTH CAROLINA 29526**

DOCUMENT TYPE OF INSTRUMENT BEING FILED: Restrictions

DATE OF INSTRUMENT: .

DOCUMENT SHALL BE RETURNED TO:

NAME: McCabe Trotter & Beverly, PC

ADDRESS:

4500 Fort Jackson Blvd.

Suite 250

Columbia, SC 29202

TELEPHONE: (803) 724-5000

FAX: (803) 724-5000

E-MAIL ADDRESS: stephanie.trotter@mccabetrotter.com

Related Document(s): book 1155 , page 524

PURCHASE PRICE / MORTGAGE AMOUNT: \$,

BRIEF PROPERTY DESCRIPTION: NORTH POINTE

TAX MAP NUMBER (TMS #) n/a / PIN NUMBER: .

GRANTOR / MORTGAGOR / OBLIGOR / MARKER (FROM WHO):


FULL BUSINESS NAME

1. NORTH POINTE DEVELOPMENT, INC.

GRANTEE / MORTGAGEE / OBLIGEE (TO WHO):

FULL BUSINESS NAME

1. NORTH POINTE DEVELOPMENT HOMEOWNERS ASSOCIATION, INC.

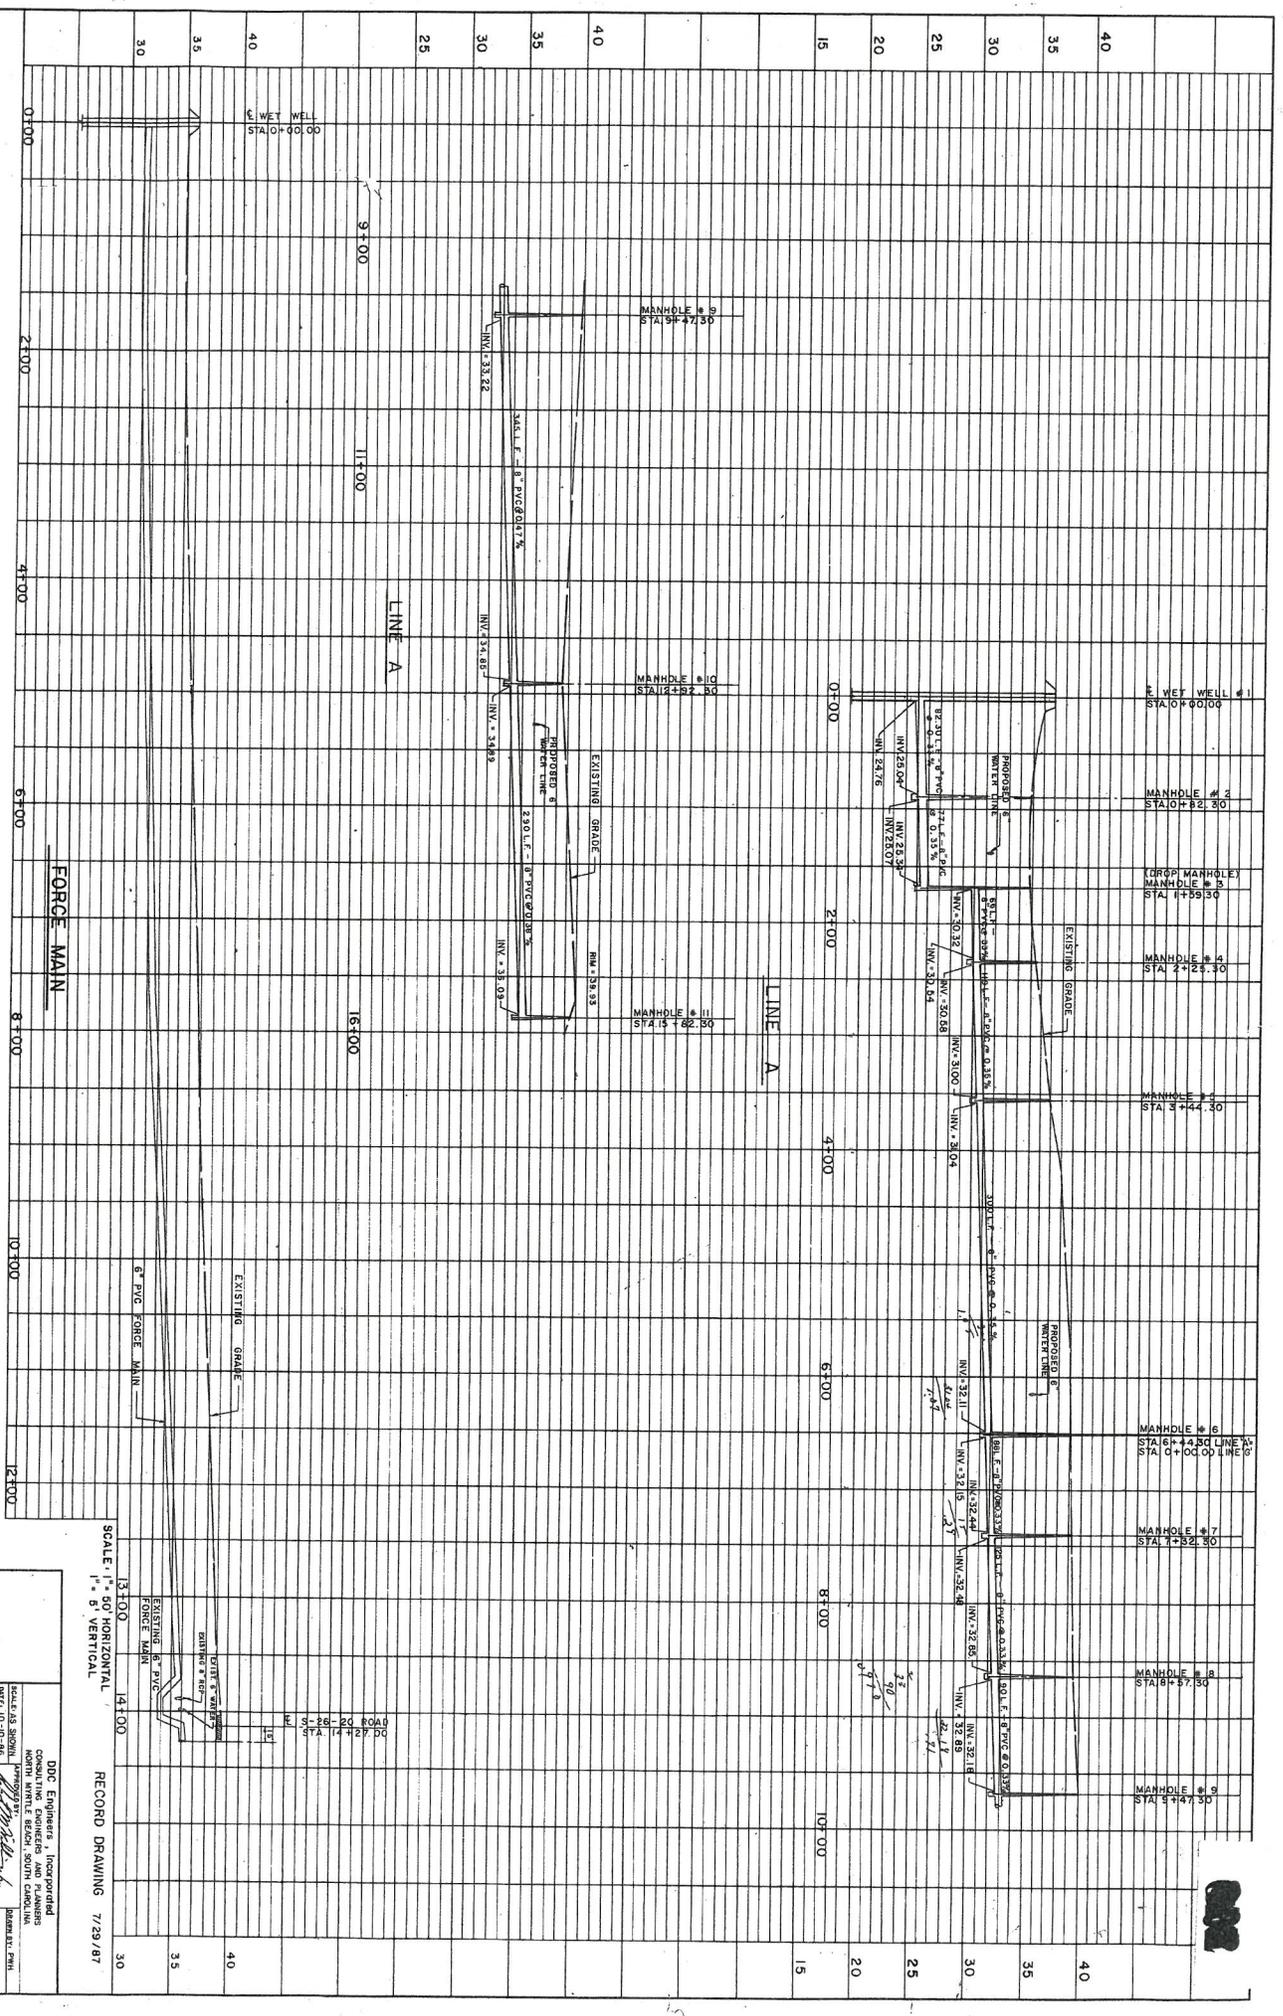

02-046



SCALE: 1" = 8' HORIZONTAL
1" = 8' VERTICAL

RECORD DRAWING 7/29/87

DDC Engineers, Incorporated CONSULTING ENGINEERS AND PLANNERS 1000 S. W. 10TH AVENUE, SUITE 100 MIAMI, FL 33135	
DATE: 10-10-86	DESIGNED BY: <i>[Signature]</i>
SANITARY SEWER PROFILES	
NORTH POINT	
NORTH WASTE RECH. SOUTH CORKUM	
DATE: 10-10-86	REVISION: 1
DATE: 10-10-86	REVISION: 2
DATE: 10-10-86	REVISION: 3
DATE: 10-10-86	REVISION: 4
DATE: 10-10-86	REVISION: 5
DATE: 10-10-86	REVISION: 6
DATE: 10-10-86	REVISION: 7
DATE: 10-10-86	REVISION: 8
DATE: 10-10-86	REVISION: 9
DATE: 10-10-86	REVISION: 10



PROPOSED FORCE MAIN PLAN

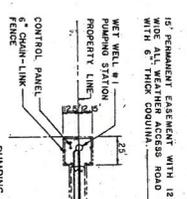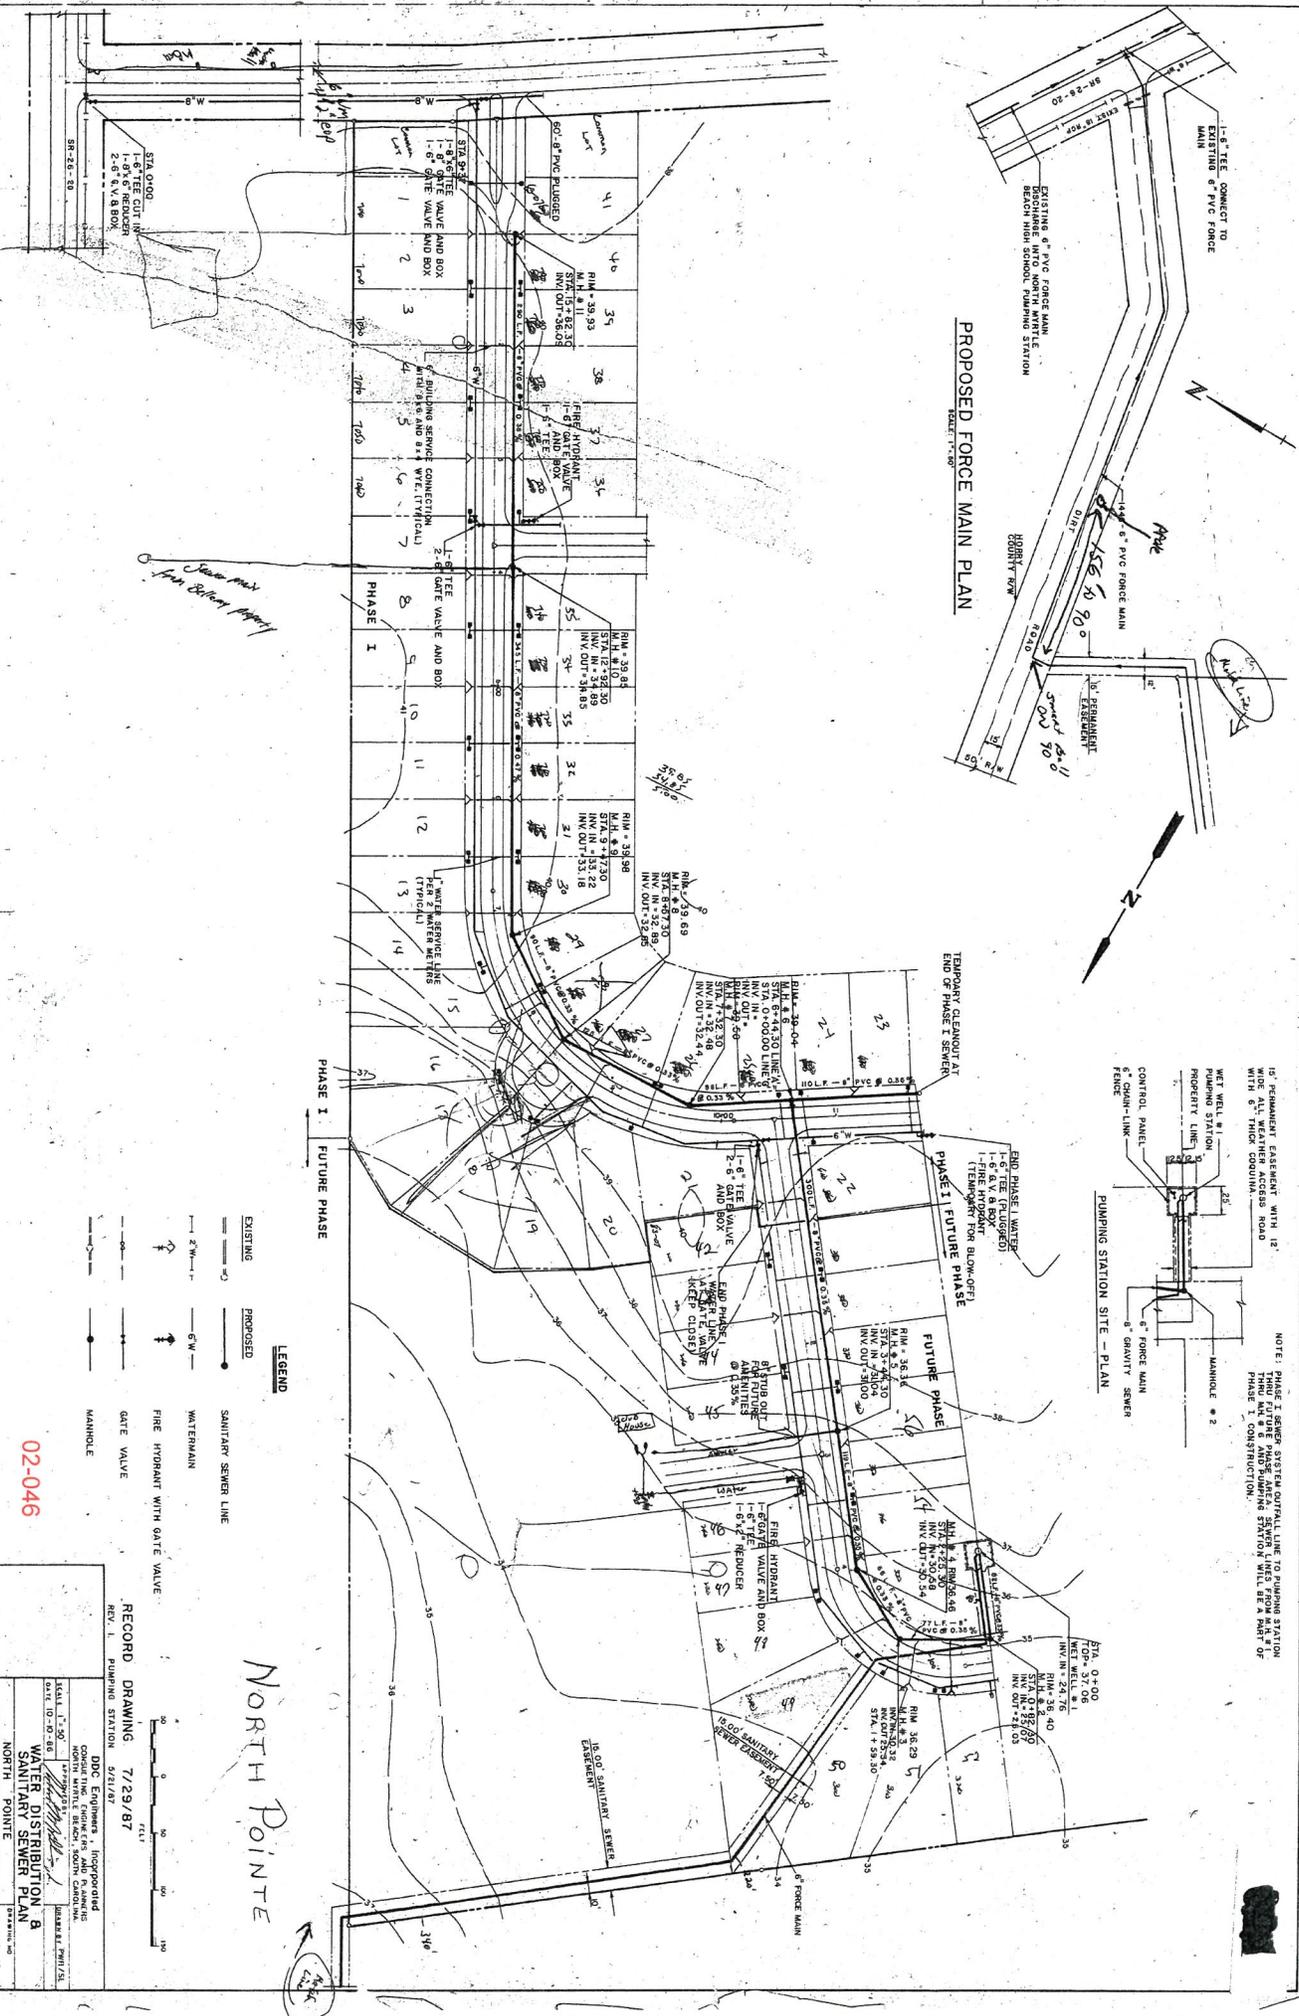

NOTE: PHASE I SEWER SYSTEM OVERTALL LINE TO PUMPING STATION THROUGH ALL 8' AND 10' WIDE EASEMENTS WILL BE PART OF PHASE I CONSTRUCTION.

LEGEND

	EXISTING		PROPOSED
	MANHOLE		

02-046

RECORD DRAWING 7/29/87
REV. 1. PUMPING STATION 5/21/87

DDC Engineers, Incorporated
CONSULTING ENGINEERS AND ARCHITECTS
1000 W. 10th Street, Suite 1000, Tallahassee, Florida 32301
TEL: 904-224-1111
FAX: 904-224-1112

WATER DISTRIBUTION & SANITARY SEWER PLAN
NORTH POINTE
SHEET NO. 4 OF 10

NORTH POINTE